

**ASTM E 1886 and ASTM E 1996  
TEST REPORT**

**Report No.:** B2778.02-701-18

**Rendered to:**

PRL ARCHITECTURAL ALUMINUM PRODUCTS

**PRODUCT TYPE:** Aluminum Framed Curtainwall System  
**SERIES/MODEL:** CW-600

**This report contains in its entirety:**

**Cover Page:** 1 page  
**Report Body:** 8 pages  
**Sketches:** 1 pages  
**Drawings:** 12 pages

**Test Dates:** 08/31/11

**Through:** 09/01/11

**Report Date:** 10/04/11

**Test Record Retention End Date:** 09/01/15

**1.0 Report Issued To:** PRL Architectural Aluminum Products  
14760 Don Julian Road  
City of Industry, California 91746

**2.0 Test Laboratory:** Architectural Testing, Inc.  
4 Rancho Circle  
Lake Forest, California 92630  
949.460.9600

**3.0 Project Summary:**

**3.1 Product Type:** Aluminum Framed Curtainwall System

**3.2 Series/Model:** CW-600

**3.3 Compliance Statement:** Results obtained are tested values and were secured by using the designated test method(s). The samples tested met the performance requirements set forth in the referenced test procedures for a +1676/-2873 Pa (+35/-60 psf) Design Pressure with missile impacts corresponding to Missile Level D and Wind Zone 3 for a basic protection rating.

**3.4 Test Dates:** 08/31/2011 - 09/01/2011

**3.5 Test Location:** Architectural Testing, Inc. test facility in Lake Forest, California. Calibration of test equipment was performed by Architectural Testing in accordance with AAMA 205-01 "In-Plant Testing Guidelines for Manufacturers and Independent Laboratories".

**3.6 Test Sample Source:** The test specimen was provided by the client. Representative samples of the test specimen(s) will be retained by Architectural Testing for a minimum of four years from the test completion date.

**3.7 Drawing Reference:** The test specimen drawings have been reviewed by Architectural Testing and are representative of the test specimen(s) reported herein. Test specimen construction was verified by Architectural Testing per the drawings located in Appendix B. Any deviations are documented herein or on the drawings.

**3.8 List of Official Observers:**

<u>Name</u>	<u>Company</u>
Frank Fisher	PRL Architectural Aluminum Products
John S. Mayfield	Architectural Testing, Inc.

#### 4.0 Test Specification(s):

ASTM E 1886-05, *Standard Test Method for Performance of Exterior Windows, Curtain Walls, Doors and Storm Shutters Impacted by Missile(s) and Exposed to Cyclic Pressure Differentials.*

ASTM E 1996-05, *Standard Specification for Performance of Exterior Windows, Glazed Curtain Walls, Doors and Storm Shutters Impacted by Wind Borne Debris in Hurricanes.*

#### 5.0 Test Specimen Description:

##### 5.1 Product Sizes:

##### Test Specimens #1 - #3:

Overall Area: 12.3 m <sup>2</sup> (132.4 ft <sup>2</sup> )	Width		Height	
	millimeters	inches	millimeters	inches
Overall size	4636	182-1/2	2654	104-1/2

##### 5.2 Frame Construction:

Frame Member	Material	Description
Vertical Mullion	Extruded aluminum	
Pressure plate closer	Extruded aluminum	Secured to each jamb and at the head and sill of each lite using one (1) #12 x 3/4" "B" point hex head screw located 2" on center from the ends and 12" on center thereafter
Pressure plate	Extruded aluminum	Secured to each vertical mullion using one (1) #12 x 3/4" "B" point hex head screw located 2" on center from the ends and 12" on center thereafter
Angle bracket	Extruded aluminum	Secured to the ends of each horizontal member using two (2) #10 x 1/2" phillips pan head sheet metal screws and secured to the ends of each vertical member using two (2) phillips pan sheet metal screws

	Joinery Type	Detail
All corners	Horizontal to vertical framing members	Butted and secured using a custom shaped aluminum angle bracket (P/N: CW-306-F01)

**5.0 Test Specimen Description:** (Continued)

**5.3 Weatherstripping:** No weatherstripping was utilized.

**5.4 Glazing:**

Exterior Lite	Spacer	Interior Lite		
3/16" heat strengthened	3/8" aluminum box	3/16" heat strengthened	0.060" DuPont SentryGlas®	3/16" heat strengthened

Glass Type	Overall Glass Thickness	Glazing Method
Laminated	1" I.G.	Dry glazed with compression gasket at the interior and exterior and secured full perimeter of each lite at the exterior with an aluminum pressure plate.

Daylight Opening		Glass Bite
millimeters	inches	
1492 x 2559	58-3/4 x 100-3/4	5/8"

**5.5 Drainage:**

Drainage Method	Size	Quantity	Location
Weep holes	3/8" diameter	2/lite	6" on center from the ends through the pressure bar and pressure bar cap

**5.6 Hardware:** No hardware was utilized.

**5.7 Reinforcement:** No reinforcement was utilized.

**6.0 Installation:**

The specimen was installed into an aluminum test buck. The rough opening allowed for a 1/4" shim space. The exterior perimeter of the window was sealed with duct tape.

**6.0 Installation:** (Continued)

<b>Location</b>	<b>Anchor Description</b>	<b>Anchor Location</b>
Ends of each jamb member	Custom shaped extruded aluminum angle clip (P/N: AB-1), secured to the frame and test buck, each using 4 (four) #12 x 1-1/4" hex head screws	Two (2) per member; located at the interior side of each jamb above the head member and below the sill member
Ends of each vertical mullion member	Custom shaped extruded aluminum angle clip (P/N: AB-1), secured to the frame and test buck, each using 4 (four) #12 x 1-1/4" hex head screws	Four (4) per member; located on each side of the vertical mullion members above the head member and below the sill member

**7.0 Test Results:** The results are tabulated as follows:

**ASTM E 1886, Large Missile Impact**

**Conditioning Temperature:** 26°C (78°F)  
**Missile Weight:** 4173 g (9.20 lbs)  
**Missile Length:** 2.4 m (94")  
**Muzzle Distance from Test Specimen:** 4.4 m (14'-6")

**Test Unit #1:** Orientation within ±5° of horizontal

<b>Impact #1:</b> Missile Velocity: 15.4 m/s (50.5 fps)	
<b>Impact Area:</b>	Center of left lite
<b>Observations:</b>	Missile penetrated the interior plane of the glazing causing an approximate 2" x 4" rupture in the glass.
<b>Results:</b>	Pass

**Test Unit #2:** Orientation within ±5° of horizontal

<b>Impact #1:</b> Missile Velocity: 15.4 m/s (50.4 fps)	
<b>Impact Area:</b>	Bottom left corner of center lite
<b>Observations:</b>	Missile penetrated the interior plane of the glazing causing an approximate 2" x 4" rupture in the glass.
<b>Results:</b>	Pass

**Test Unit #3:** Orientation within ±5° of horizontal

<b>Impact #1:</b> Missile Velocity: 15.4 m/s (50.4 fps)	
<b>Impact Area:</b>	Top right corner of right lite
<b>Observations:</b>	Missile penetrated the interior plane of the glazing causing an approximate 2" x 4" rupture in the glass.
<b>Results:</b>	Pass

**Note:** See Architectural Testing Sketch #1 for impact locations.

**7.0 Test Results:** (Continued)

**ASTM E 1886, Air Pressure Cycling**

**Test Unit #2**

**Design Pressure:** +1676/-2873 Pa (+35/-60 psf)

**POSITIVE PRESSURE**

Pressure Range Pa (psf)	Number of Cycles	Average Cycle Time (seconds)	Maximum Deflection at Indicator mm (inches)		
			#1	#2	#3
335 to 838 (7.0 to 17.5)	3500	2.80	0.8 (0.03)	4.3 (0.17)	0.8 (0.03)
0 to 1005 (0 to 21.0)	300	2.92	1.0 (0.04)	5.8 (0.23)	1.0 (0.04)
838 to 1341 (17.5 to 28)	600	2.71	1.8 (0.07)	7.6 (0.30)	1.3 (0.05)
503 to 1676 (10.5 to 35)	100	3.99	2.0 (0.08)	9.1 (0.36)	1.5 (0.06)
			Permanent Set mm (inches)		
			0.5 (0.02)	1.0 (0.04)	0.5 (0.02)

**NEGATIVE PRESSURE**

Pressure Range Pa (psf)	Number of Cycles	Average Cycle Time (seconds)	Maximum Deflection at Indicator mm (inches)		
			#1	#2	#3
862 to 2873 (18.0 to 60.0)	50	4.00	10.2 (0.40)	26.0 (1.02)	10.2 (0.40)
1436 to 1915 (30.0 to 48.0)	1050	3.13	7.4 (0.29)	17.0 (0.67)	4.8 (0.19)
0 to 1724 (0 to 36.0)	50	3.98	4.3 (0.17)	9.9 (0.39)	2.3 (0.09)
575 to 1436 (12.0 to 30.0)	3350	2.79	3.8 (0.15)	8.9 (0.35)	2.3 (0.09)
			Permanent Set mm (inches)		
			0.3 (0.01)	0.3 (0.01)	0.3 (0.01)

**Observations:** No additional damage or deglazing was observed.

**Result:** Pass

**Note:** See Architectural Testing Sketch #1 for indicator locations. Test Specimens were installed and cycled as a unitized system.

**General Note:** *Upon completion of testing, the specimens met the requirements of Section 7.1.1.1 of ASTM E 1996, for basic protection.*

## **8.0 Test Equipment:**

**Cannon:** Constructed from steel piping utilizing compressed air to propel the missile

**Missile:** 2x4 Southern Pine

**Timing Device:** Electronic Beam Type

**Cycling Mechanism:** Computer controlled centrifugal blower with electronic pressure measuring device

**Deflection Measuring Device:** Linear transducers

Tape and film were used to seal against air leakage during structural testing. In our opinion, the tape and film did not influence the results of the test.



The service life of this report will expire on the stated Test Record Retention End Date, at which time such materials as drawings, data sheets, samples of test specimens, copies of this report, and any other pertinent project documentation, shall be discarded without notice.

If test specimen contains glazing, no conclusions of any kind regarding the adequacy or inadequacy of the glass in any glazed test specimen(s) can be made. This report does not constitute certification of this product nor an opinion or endorsement by this laboratory. It is the exclusive property of the client so named herein and relates only to the specimen(s) tested. This report may not be reproduced, except in full, without the written approval of Architectural Testing, Inc.

For ARCHITECTURAL TESTING, Inc.

---

John S. Mayfield  
Project Manager

---

Shawn G. Collins, P.E.  
Laboratory Support Engineer

JM:bu

Attachments (pages): This report is complete only when all attachments listed are included.


Appendix-A: Sketches (1)

Appendix-B: Drawings (12)

Test Report No.: B2778.02-701-18  
Report Date: 10/04/11  
Test Record Retention End Date: 09/01/15

## **Appendix A**

### **Sketches**

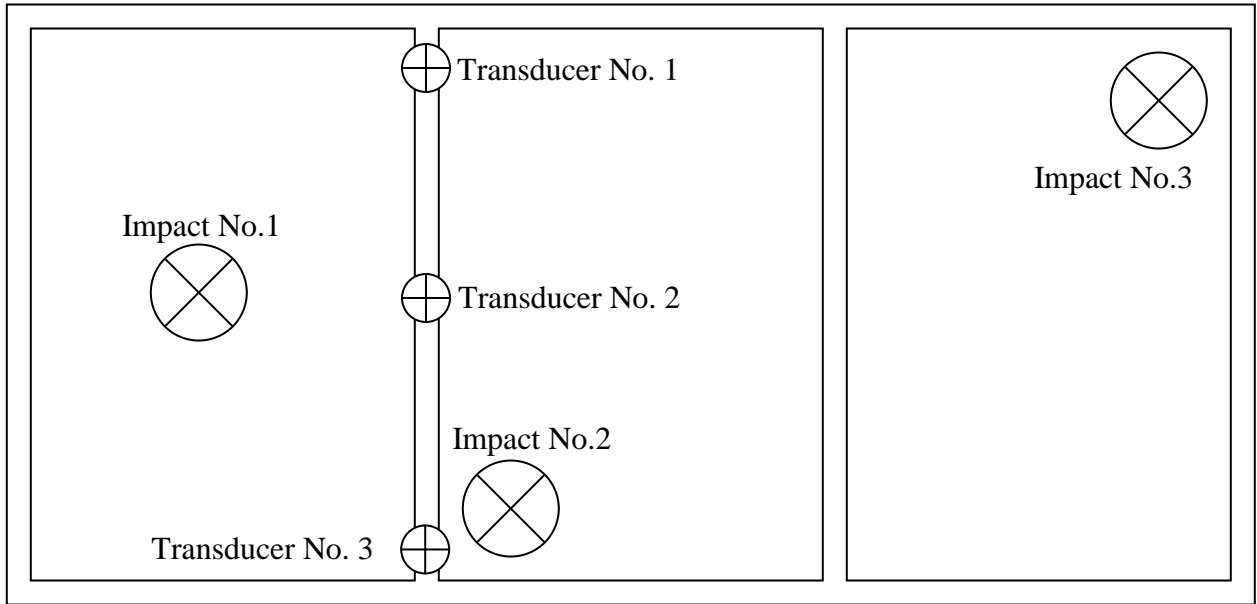

*Sketch # 1: Impact and Linear Transducer Locations*

Test Report No.: B2778.02-701-18  
Report Date: 10/04/11  
Test Record Retention End Date: 09/01/15

## **Appendix B**

### **Drawings**

**PRL 2 1/2" x 6" curtain wall CW-600 series**

Bill of Material

PRL part number	manufacturer	description	qty required	size	
CW-601	PRL proprietary	vertical mullion	4	H	116 1/2"
CW-102	PRL proprietary	pressure plate closer	2	H	116 1/2"
CW-101	PRL proprietary	pressure plate	2	H	116 1/2"
CW-201	PRL proprietary	snap cap trim	4	H	116 1/2"
CW-602	PRL proprietary	horizontal mullion	6	W DLO	57 1/2"
400FF	PRL proprietary	horizontal mullion filler	6	W DLO - 1/32"	57 15/32"
CW-102	generic	pressure plate closer	6	W DLO - 1/4"	57 1/4"
CW-201	PRL proprietary	snap cap trim	6	W DLO - 1/16"	57 7/16"
AB-1	PRL	ANCHOR CLIP	12		
CW-306-F01	PRL	ANGLE CLIP/CORNERS	12		
WS-1	PRL	GLAZING GASKET	AS REQ'D		
		insulated glass width	3	DLO + 1 1/4"	
		insulated glass height	3	DLO + 1 1/4"	

W = width

H = height

DLO = day light opening






Test sample complies with these details.  
Deviations are noted.

Report# B277801  
Date 9/27 Tech [Signature]




Test sample complies with these details.  
Deviations are noted.

Report# B2778.02  
Date 9/27 Tech [Signature]

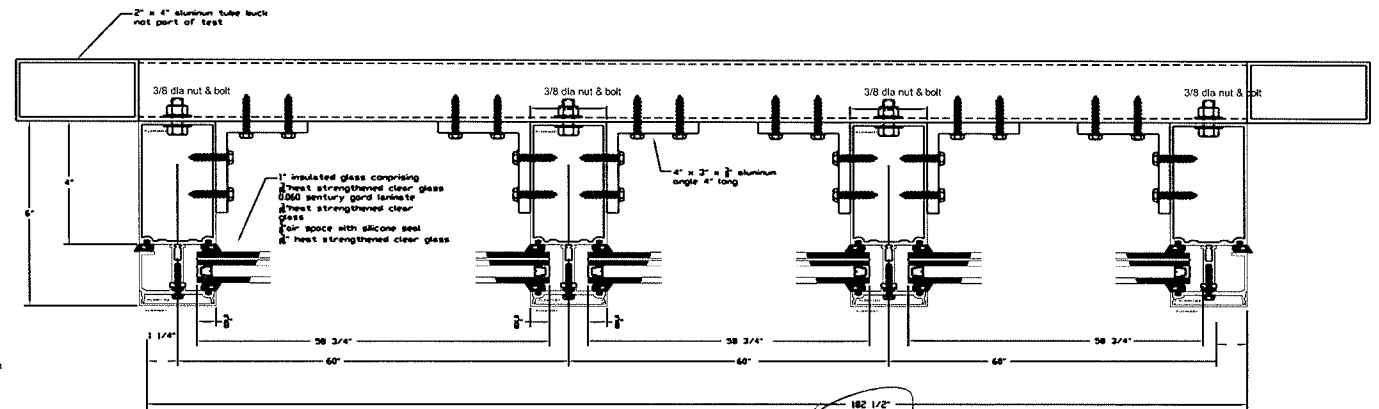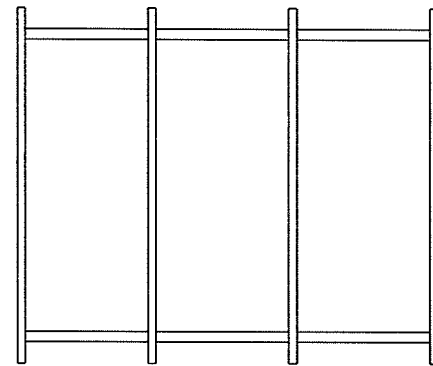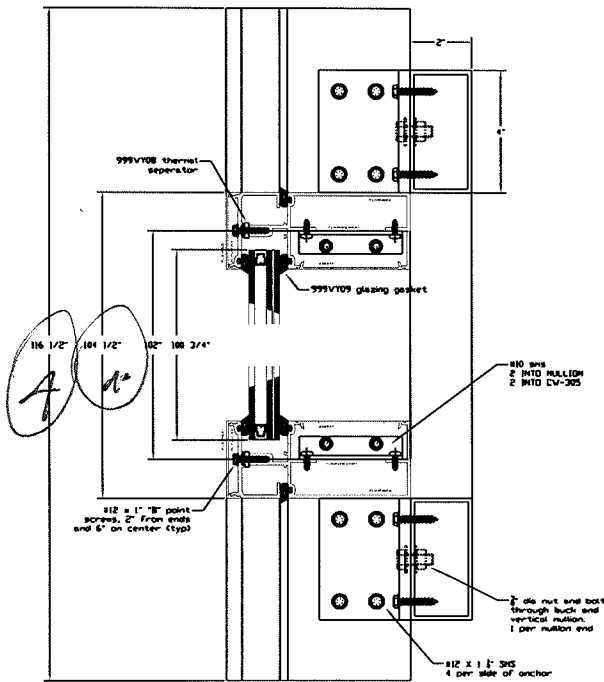


+35/-60 psf

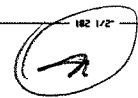

UNLESS OTHERWISE SPECIFIED STANDAR ALUMINUM ASSOCIATION TOLERANCES APPLY


DIE NO. X

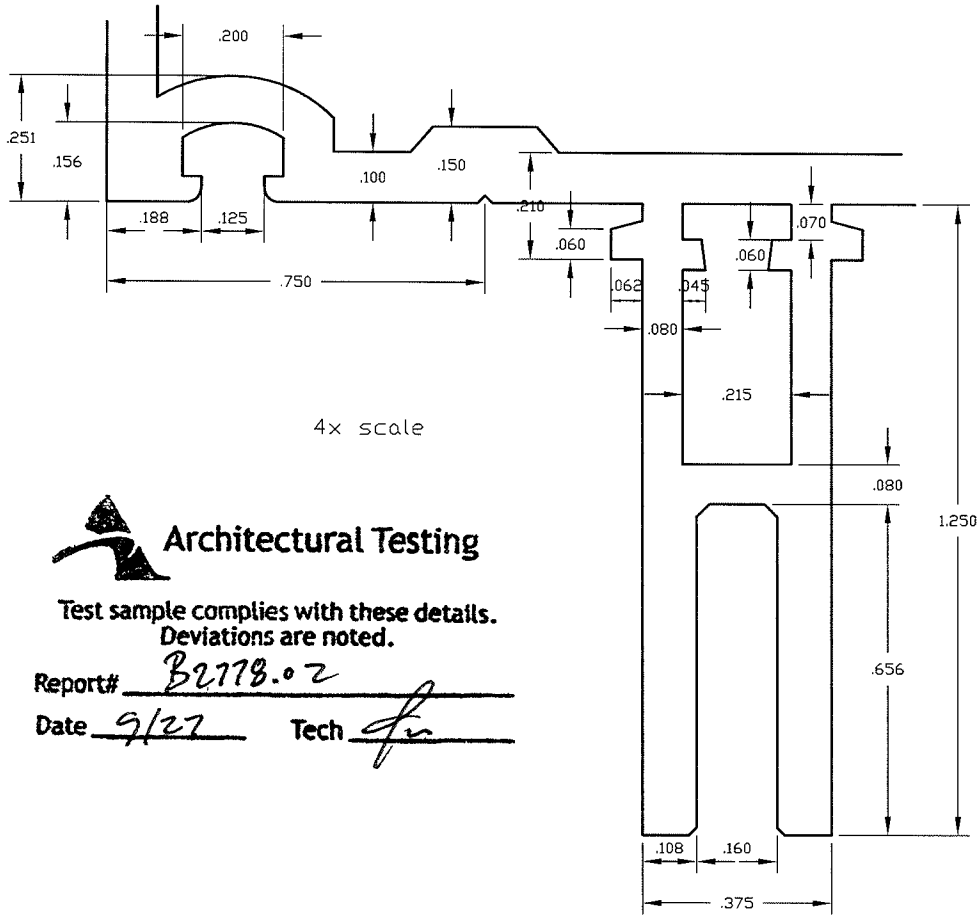

**Architectural Testing**

Test sample complies with these details.  
Deviations are noted.

Report# B2778.02  
Date 9/27 Tech fu

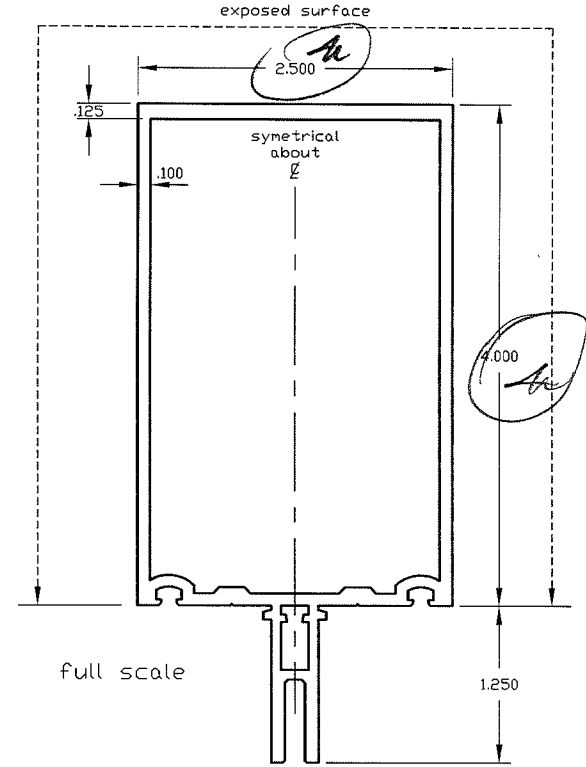

UNLESS OTHER WISE NOTED

TYP. WALL

UNMARKED CORNERS .020 R.

SCALE 1 2 3

REVISION	CUSTOMER: ALUMINUM STOREFRONTS		<b>PRL</b> ALUMINUM INC. 14760 DON JULIAN RD. INDUSTRY CA. 91746 TEL. ( 877 ) 775-2586 PRL-ALUM FAX ( 877 ) 274-8800	
	MAT'L 6063-T6	HOLES		* CRITICAL DIM
	AREA 1.647	BACKER		⊗ SPECIAL TOOL
	WT. / FT 1.976	BOLSTER		
PERI. 31.634	W/P	DRAWN: F2		
FACTOR 19	EXT. RATIO	DATE: 12-14-10	PART NAME: mullion	
C.C.D. 5.55	CLASS hollow	SCALE	PART # CW-601	

snaps with 400-FF

UNLESS OTHERWISE SPECIFIED STANDAR ALUMINUM ASSOCIATION TOLERANCES APPLY

DIE NO. X





# Architectural Testing

Test sample complies with these details.  
Deviations are noted.

Report# B2778.02

Date 9/07 Tech [Signature]

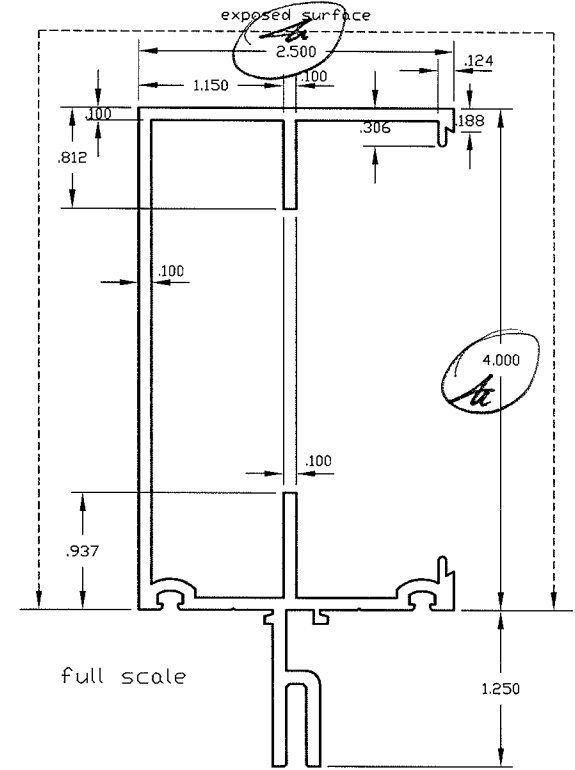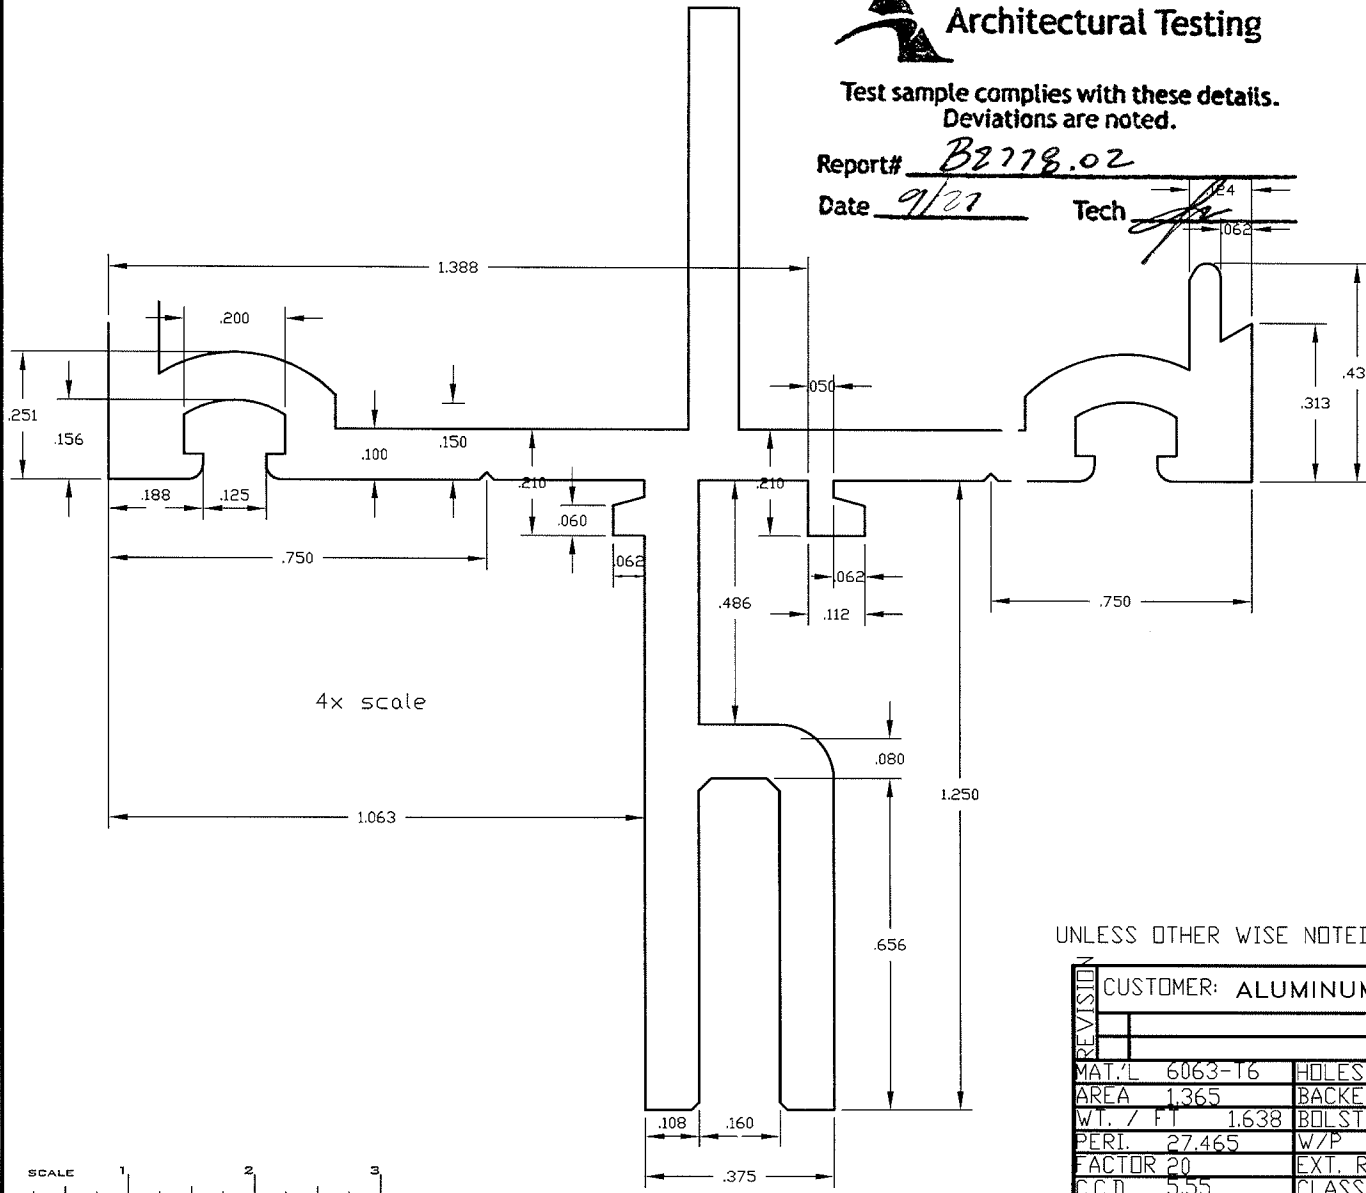

UNLESS OTHER WISE NOTED

TYP. WALL UNMARKED CORNERS .020 R.

SCALE 1 2 3

REVISION	CUSTOMER: ALUMINUM STOREFRONTS		<b>PRL</b> <b>ALUMINUM INC.</b> 14760 DON JULIAN RD. INDUSTRY CA. 91746 TEL. ( 877 ) 775-2586 PRL-ALUM FAX ( 877 ) 274-8800	
	MAT'L 6063-T6	HOLES		* CRITICAL DIM
	AREA 1.365	BACKER		⊕ SPECIAL TOOL
	WT. / FT 1.638	BOLSTER		
PERI. 27.465	W/P	DRAWN: <b>E<sup>2</sup></b>		
FACTOR 20	EXT. RATIO	DATE: 12-14-10	PART NAME: mullion	
C.C.D. 5.55	CLASS solid	SCALE	PART # CW-602	




DIE NO. X

UNLESS OTHERWISE SPECIFIED STANDAR ALUMINUM ASSOCIATION TOLERANCES APPLY

snaps with CW-201


Report# \_\_\_\_\_  
 Date \_\_\_\_\_  
 Tech \_\_\_\_\_  
 Test sample complies with these details.  
 Deviations are noted.

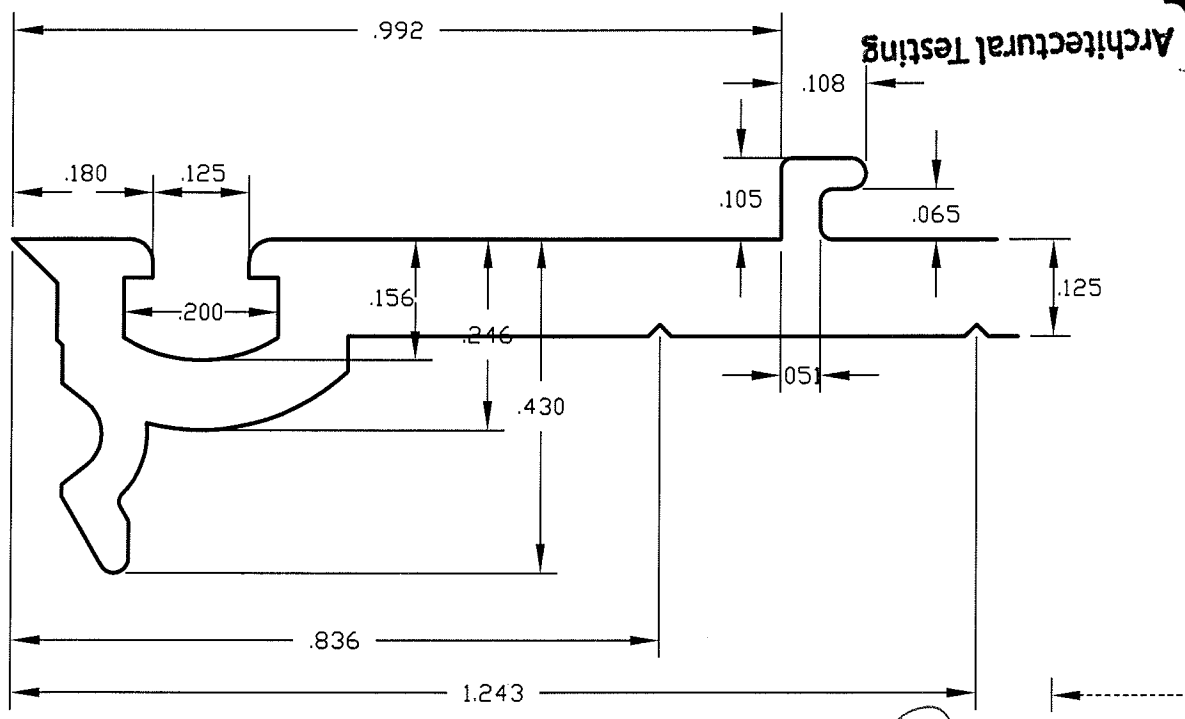

4x scale

**Architectural Testing**  
 Test sample complies with these details.  
 Deviations are noted.

Report# B2778-02  
 Date 9/22 Tech df

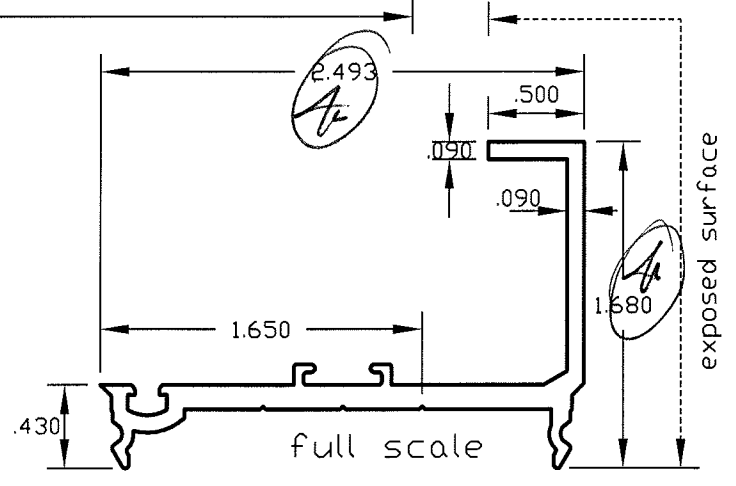

TYP. WALL


UNMARKED CORNERS .020 R.  
 UNLESS OTHER WISE NOTED

REVISION	CUSTOMER: ALUMINUM STOREFRONTS			<b>PRL</b> <b>ALUMINUM INC.</b> 14760 DON JULIAN RD. INDUSTRY CA. 91746 TEL. ( 877 ) 775-2586 PRL-ALUM FAX ( 877 ) 274-8800
	MAT'L	6063-T6	HOLES	
	AREA	0.513	BACKER	
	WT. / FT	0.616	BOLSTER	
	PERI.	10.578	W/P	
FACTOR	20	EXT. RATIO	DRAWN: <b>F2</b>	
C.C.D.	2.906	CLASS solid	DATE: 12-14-10	
			SCALE	
			PART NAME: pressure plate	
			PART # CW-102	

DIE NO. X

UNLESS OTHERWISE SPECIFIED STANDAR ALUMINUM ASSOCIATION TOLERANCES APPLY

no exposed surface  
snaps with CW-201

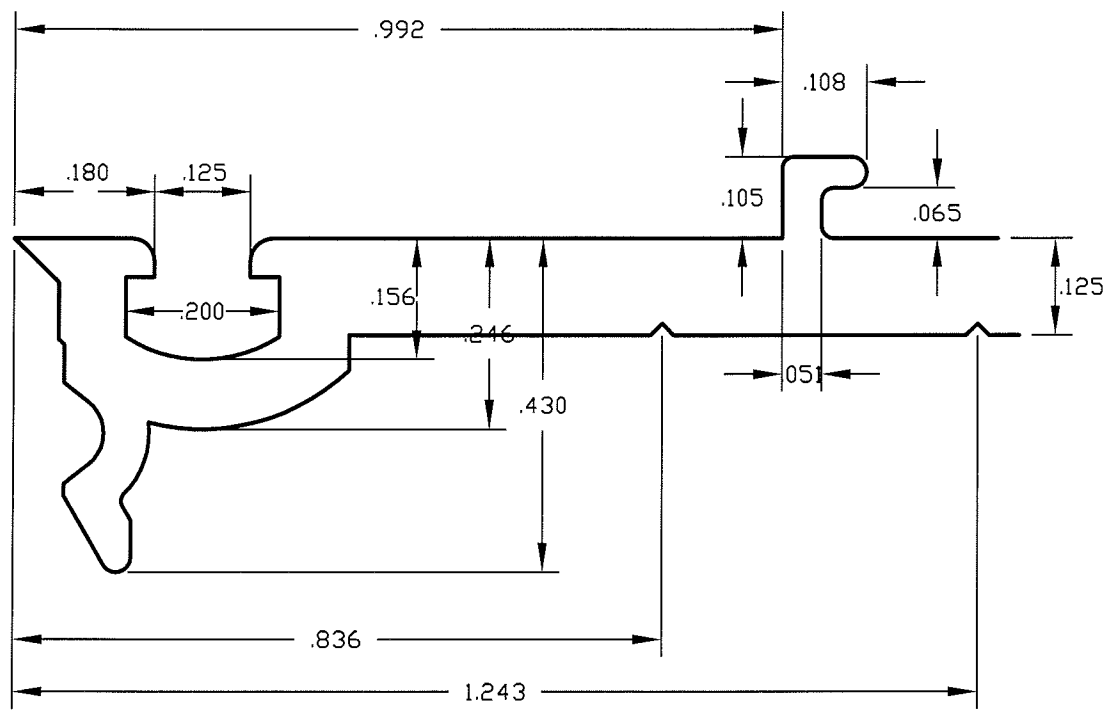


4x scale



Test sample complies with these details.  
Deviations are noted.

Report# B2778.02  
Date 9/27 Tech [Signature]

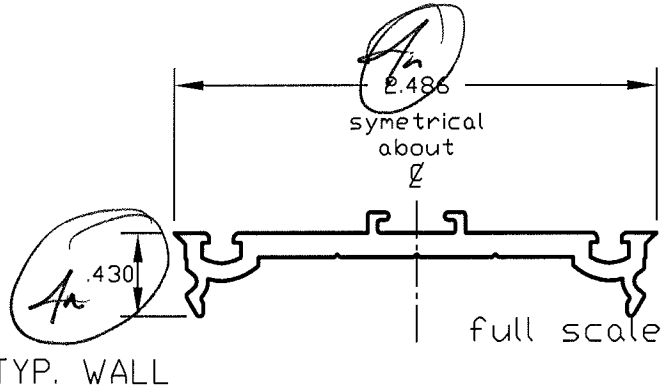


UNMARKED CORNERS .020 R.  
UNLESS OTHER WISE NOTED

REVISION	CUSTOMER: ALUMINUM STOREFRONTS			<b>PRL</b> ALUMINUM INC. 14760 DON JULIAN RD. INDUSTRY CA. 91746 TEL. ( 877 ) 775-2586 PRL-ALUM FAX ( 877 ) 274-8800
	MAT'L	6063-T6	HOLE	
	AREA	0.361	BACKER	
	WT. / FT	0.433	BOLSTER	
	PERI.	7.631	W/P	
FACTOR	21	EXT. RATIO	DATE: 12-14-10	
C.C.D.	2.486	CLASS solid	SCALE	
			* CRITICAL DIM	
			⊗ SPECIAL TOOL	
			DRAWN: F-2	
			PART NAME: pressure plate	
			PART # CW-101	

UNLESS OTHERWISE SPECIFIED STANDAR ALUMINUM ASSOCIATION TOLERANCES APPLY

DIE NO. X

snaps with CW-101

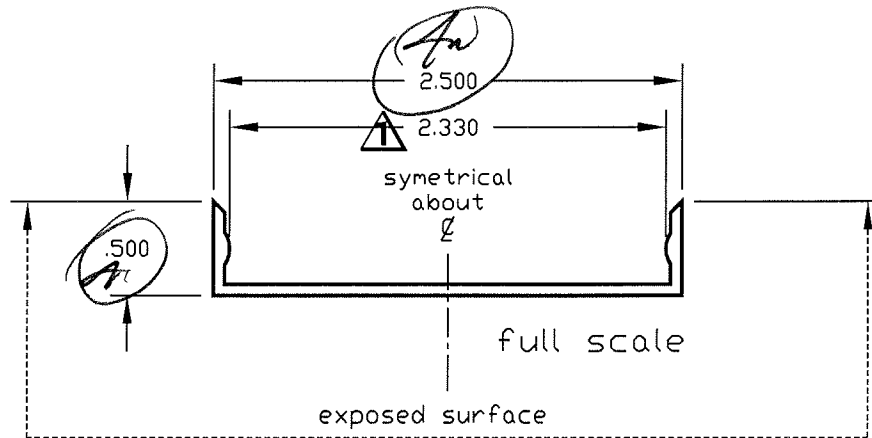


**Architectural Testing**

Test sample complies with these details.  
Deviations are noted.

Report# B2778.02  
Date 9/27 Tech dpr

8x scale

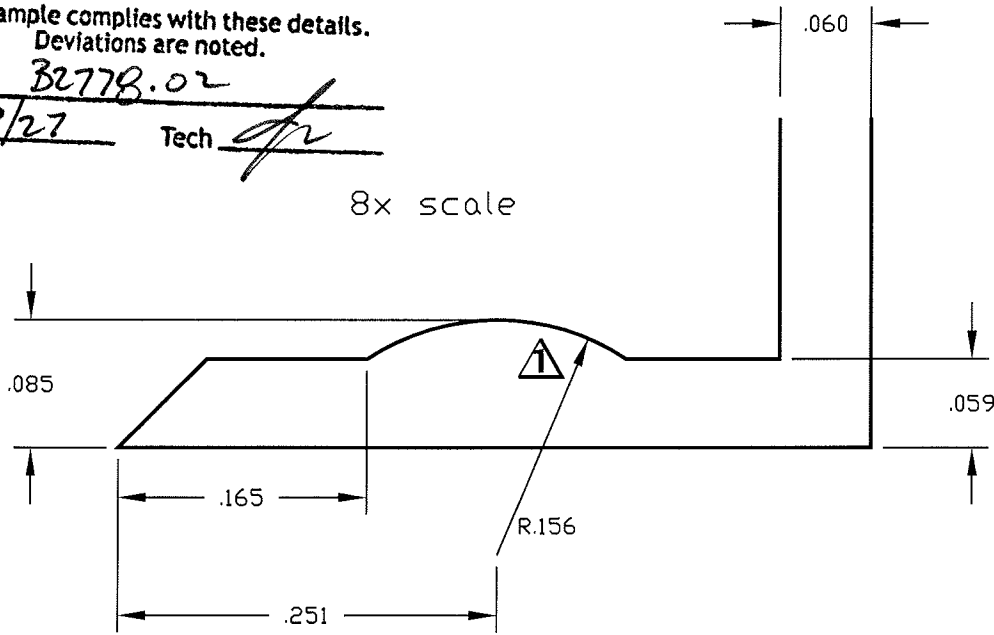

UNMARKED CORNERS .020 R.  
UNLESS OTHERWISE NOTED

TYP. WALL

REVISION

CUSTOMER: ALUMINUM STOREFRONTS

**PRL**  
ALUMINUM INC.  
14760 DON JULIAN RD.

1 reduced interference of snap. 2/15/11 F<sup>2</sup>

INDUSTRY CA. 91746  
TEL. ( 877 ) 775-2586  
PRL-ALUM  
FAX ( 877 ) 274-8800


MAT'L 6063-T6	HOLES	* CRITICAL DIM
AREA 0.205	BACKER	⊗ SPECIAL TOOL
WT. / FT 0.250	BOLSTER	
PERI. 6.831	W/P	DRAWN: F <sup>2</sup>
FACTOR 33	EXT. RATIO	DATE: 12-14-10
C.C.D. 2.550	CLASS solid	SCALE

PART NAME: snap cap  
PART # CW-201

SCALE 1 2 3

UNLESS OTHERWISE SPECIFIED STANDAR ALUMINUM ASSOCIATION TOLERANCES APPLY

DIE NO. 2051

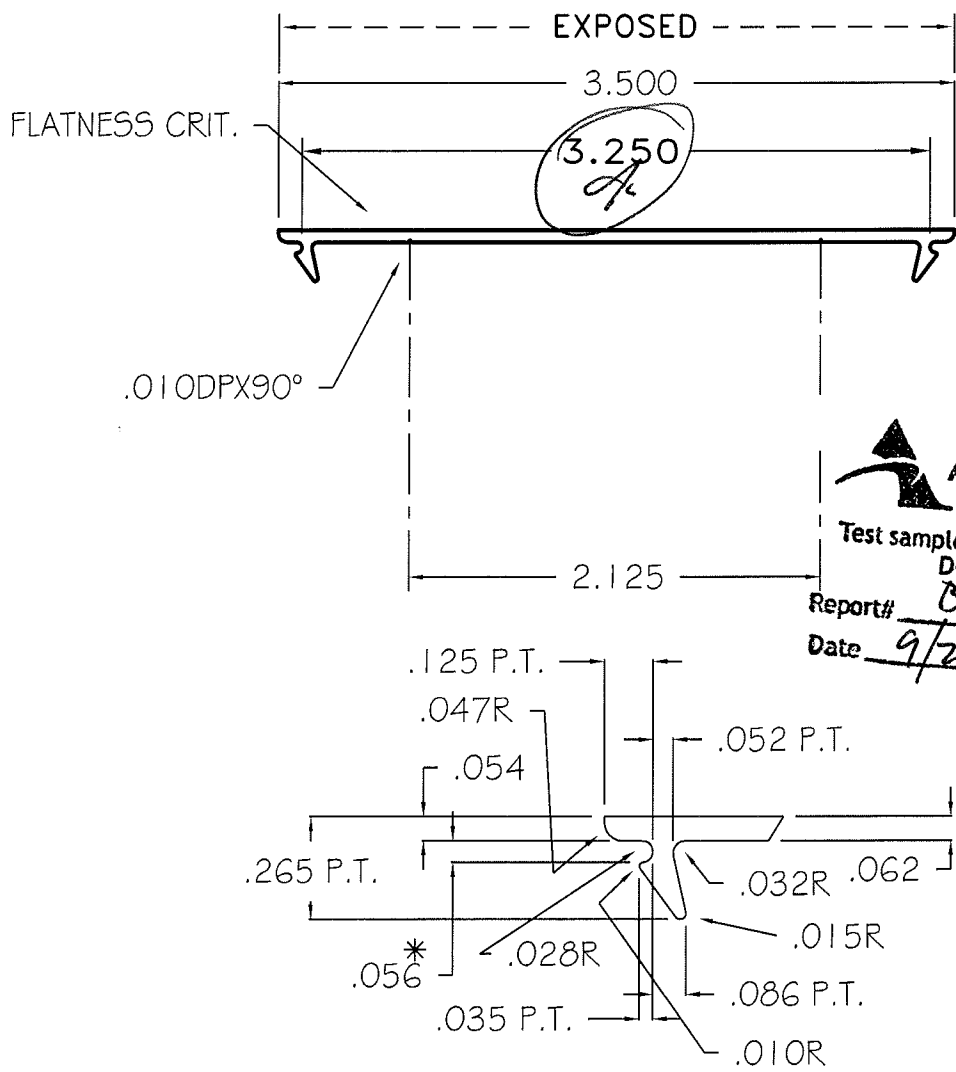


**Architectural Testing**  
 Test sample complies with these details.  
 Deviations are noted.  
 Report# B2778.02  
 Date 9/27 Tech [Signature]


UNLESS OTHER WISE NOTED .062 TYP. WALL

UNMARKED CORNERS .020 R.

REVISION	CUSTOMER:		
	MAT.'L 6063-T5	HOLES	* CRITICAL DIM.
	AREA .241	BACKER	⊗ SPECIAL TOOL
	WT. / FT .289	BOLSTER	DRAWN: OLDS 015
PERI. 7.896	W/P	DATE: 9-26-07	
FACTOR 27.32	EXT. RATIO	SCALE FULL	
C.C.D.	CLASS SOLID		

**PRL**   
**ALUMINUM INC.**  
 14760 DON JULIAN RD.  
 INDUSTRY CA. 91746  
 TEL. (877) 775-2586  
 PRL-ALUM  
 FAX (877) 274-8800

PART NAME: FLATE FILLER  
 PART # 400FF

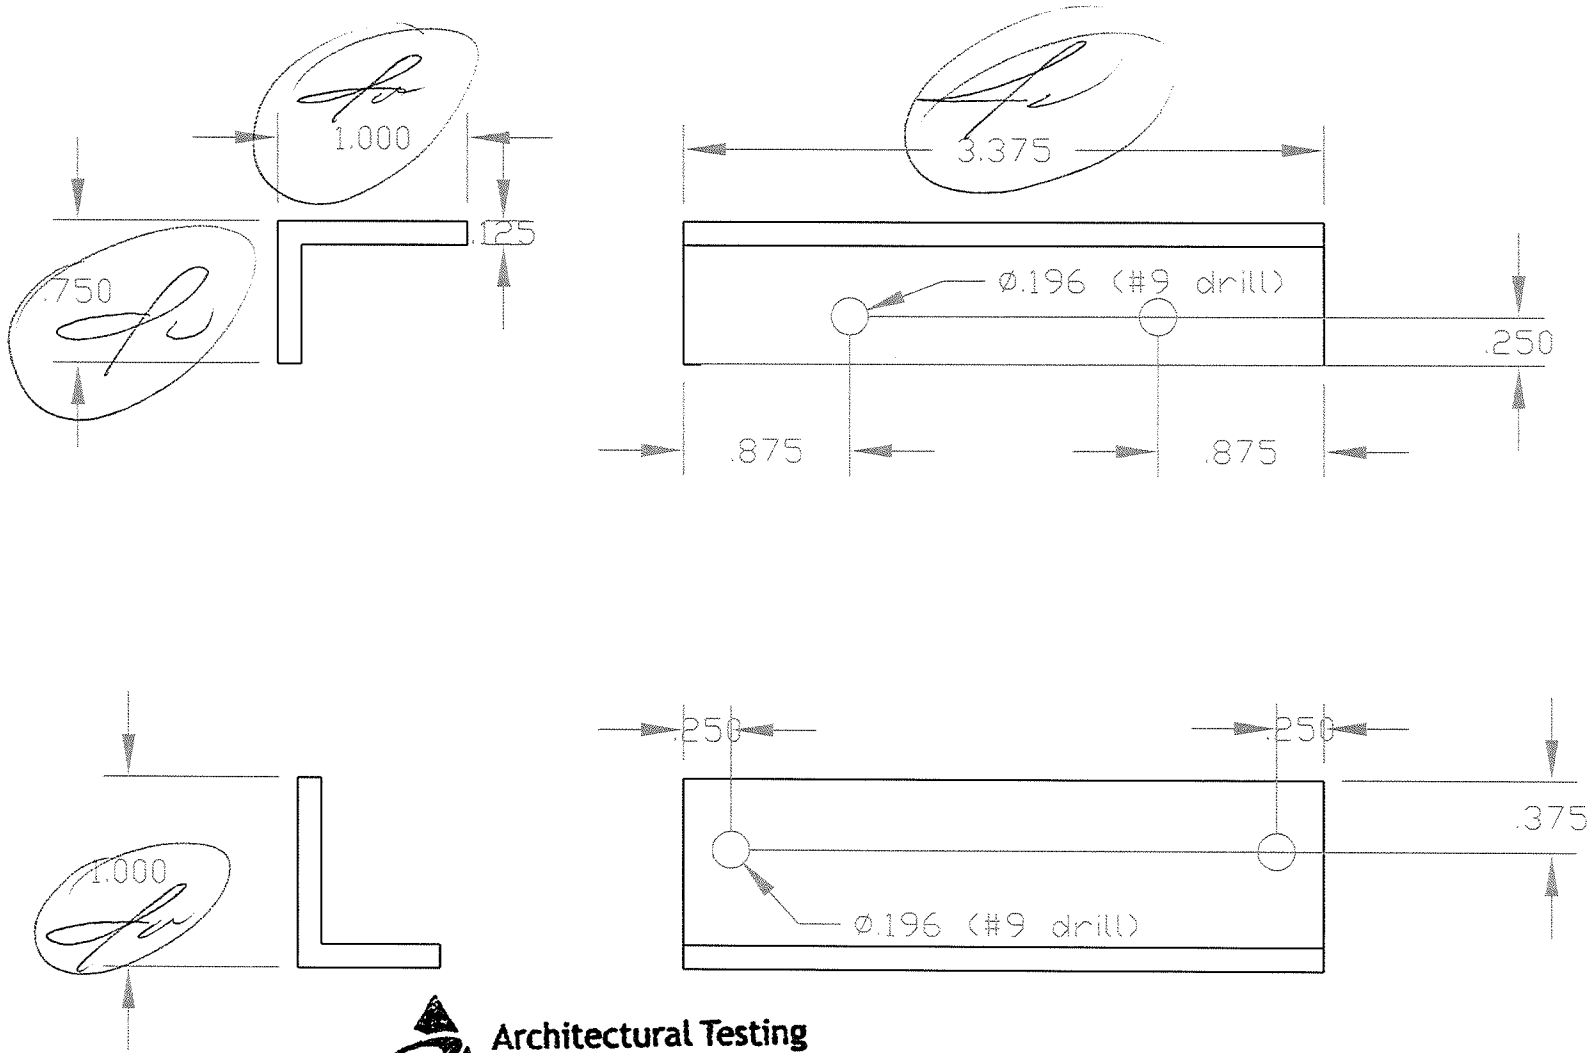


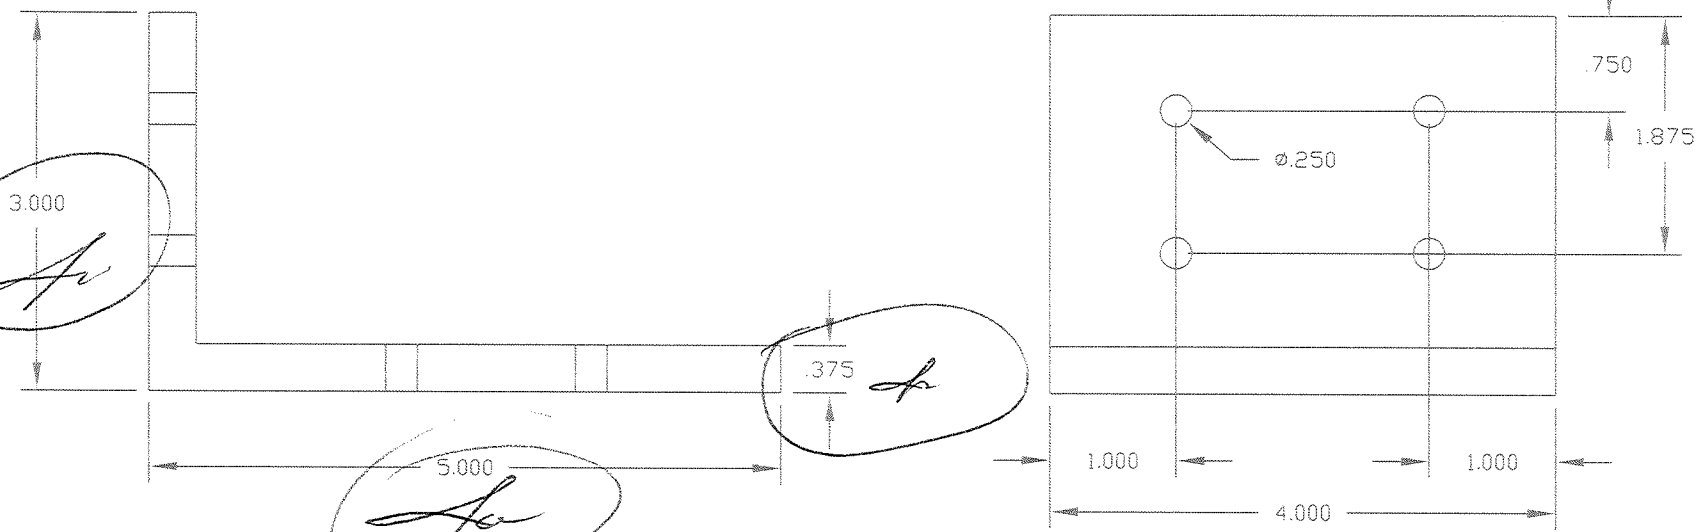
Architectural Testing  
 Test sample complies with these details.  
 Deviations are noted.  
 Report# B2778.02-701-18  
 Date 10/3/11 Tech Fu

part number: **CW-306-F01**

USE WITH CW-602 & CW-702

DRAWN <b>F<sup>2</sup></b>
DATE: 04-21-11

**PRL**   
**ALUMINUM INC.**  
 14760 DON JULIAN RD.  
 INDUSTRY CA. 91746  
 TEL. ( 877 ) 775-2586  
 PRL-ALUM  
 FAX ( 877 ) 274-8800



3.000  
*Aa*

5.000  
*Aa*

.375  
*Aa*

5.000  
*Aa*



**Architectural Testing**

Test sample complies with these details.  
Deviations are noted.

Report# B2778.02-701-18

Date 10/1/11 Tech *Aa*


*P/N: AB-91*  
**CURTAIN WALL  
ANCHOR**

DRAWN F  
DATE:

**PRL**  
ALUMINUM INC.  
14760 DON JULIAN RD.  
INDUSTRY CA. 91746  
TEL. ( 877 ) 775-2586  
PRL-ALUM  
FAX ( 877 ) 274-8800




FULL SCALE

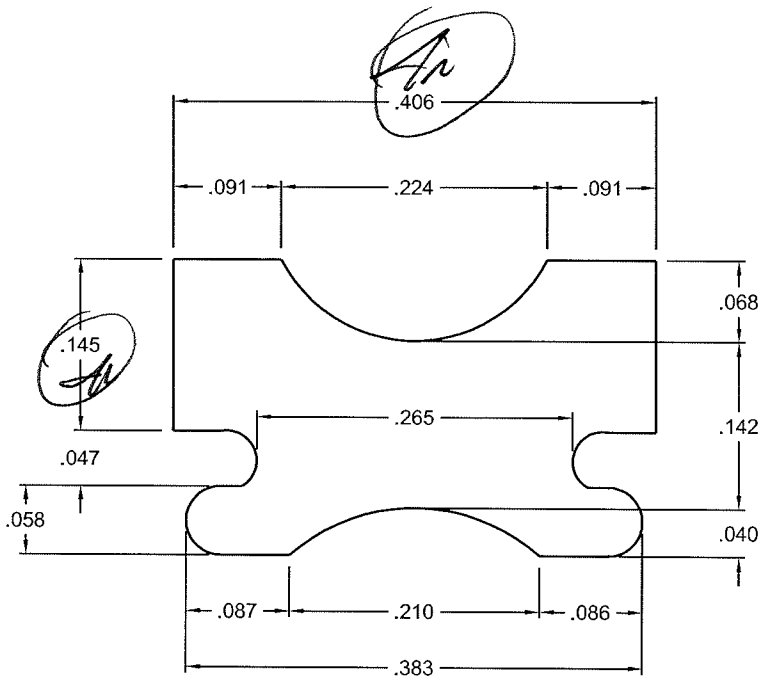

THIS DRAWING IS:  
 APPROVED  
 APPROVED AS NOTED  
 DISAPPROVED  
 DATE 12-21-40  
 BY frank fisher (PRL aluminum)

**Architectural Testing**  
 Test sample complies with these details.  
 Deviations are noted.  
 Report# B2778.02  
 Date 1/27 Tech [Signature]

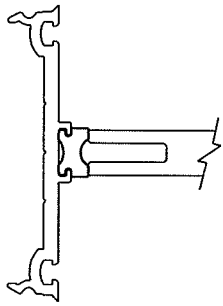

NOTE: CUT LENGTH = 10'-0" ±2.000

+ .015	+ .020	+ .025	+ .030
- .010	- .015	- .020	- .025
		± .040	
		± .035	
		± .030	
		± .025	
		± .020	
		± .015	
		± .010	

EXTRUSION CUT LENGTH   TOLERANCE	No.	Date	Description	By
0 - 1.59"				
1.6" - 2.49"				
2.5" - 3.99"				
4.0" - 6.29"				
6.3" - 9.99"				
10.0" - 15.99"				
16.0" - 24.99"				
25.0" - 39.99"				
40.0" - 62.99"				
63.0" - 99.99"				
100.0" - 159.99"				
160.0" +				


  

Customer: <b>PRL Aluminum</b>		Customer Part No.
Project:		Rev No.
Drawn by: <b>VDS</b>	Scale: <b>10X</b>	Date: <b>12/21/2010</b>
Compound: <b>Rigid PVC</b>	Designed F.C. <b>.145</b>	Drawing No. <b>999VY08</b>
Durometer: <b>GEON</b>	Area: <b>.0765</b>	

The design of the gasket shown herein is the product of Tremco Incorporated. No reproduction or use of this design is authorized without the consent of Tremco Incorporated.



FULL SCALE

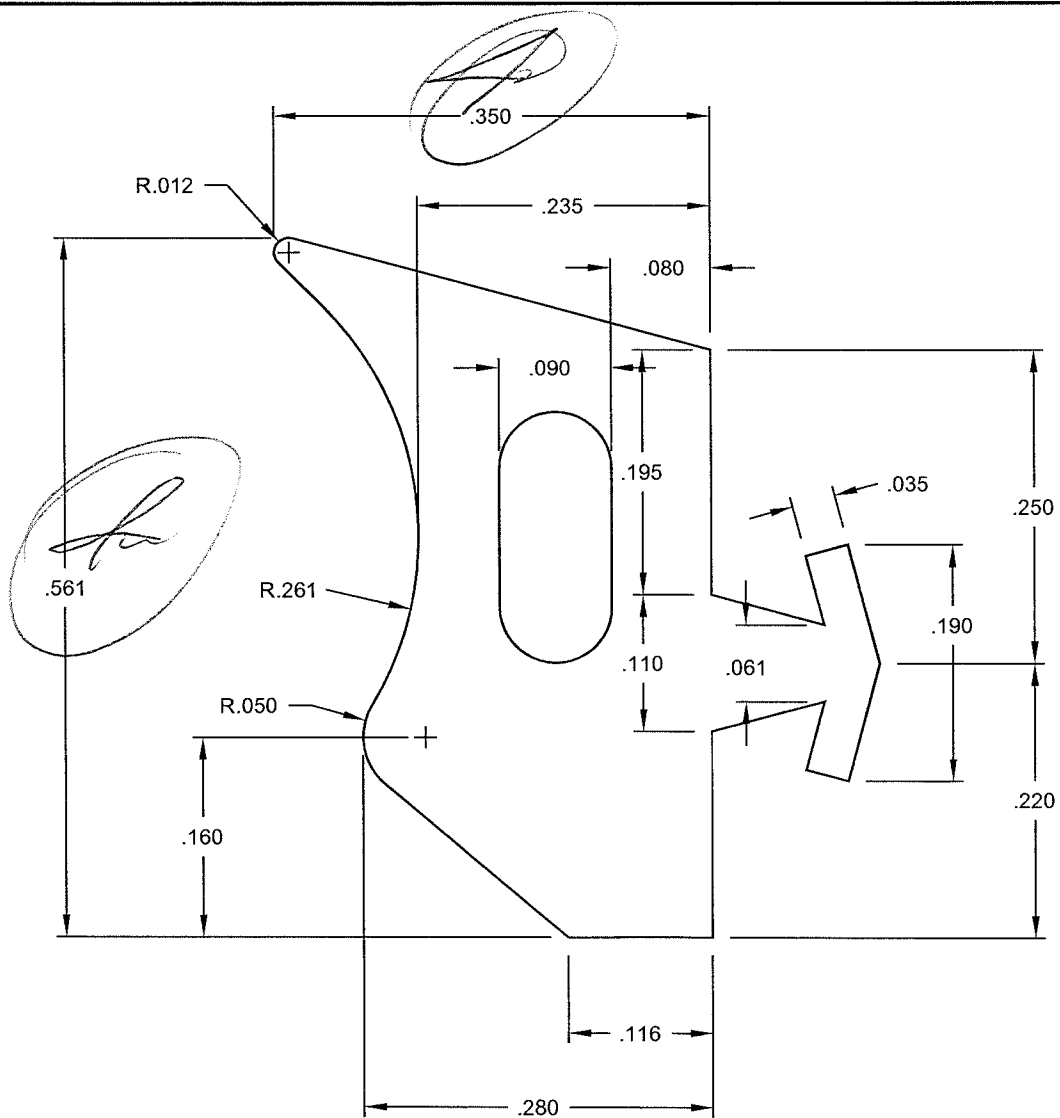

**Architectural Testing**

Test sample complies with these details.  
Deviations are noted.

Report# B2778. 02-701-18

Date 10/3 Tech [Signature]

WS-1

EXTRUSION OUT	
0	- 1
1.6"	- 2
2.5"	- 3
4.0"	- 6
6.3"	- 9
10.0"	- 15
16.0"	- 25
25.0"	- 38
40.0"	- 63
63.0"	- 98
100.0"	- 157
160.0"	+ 254